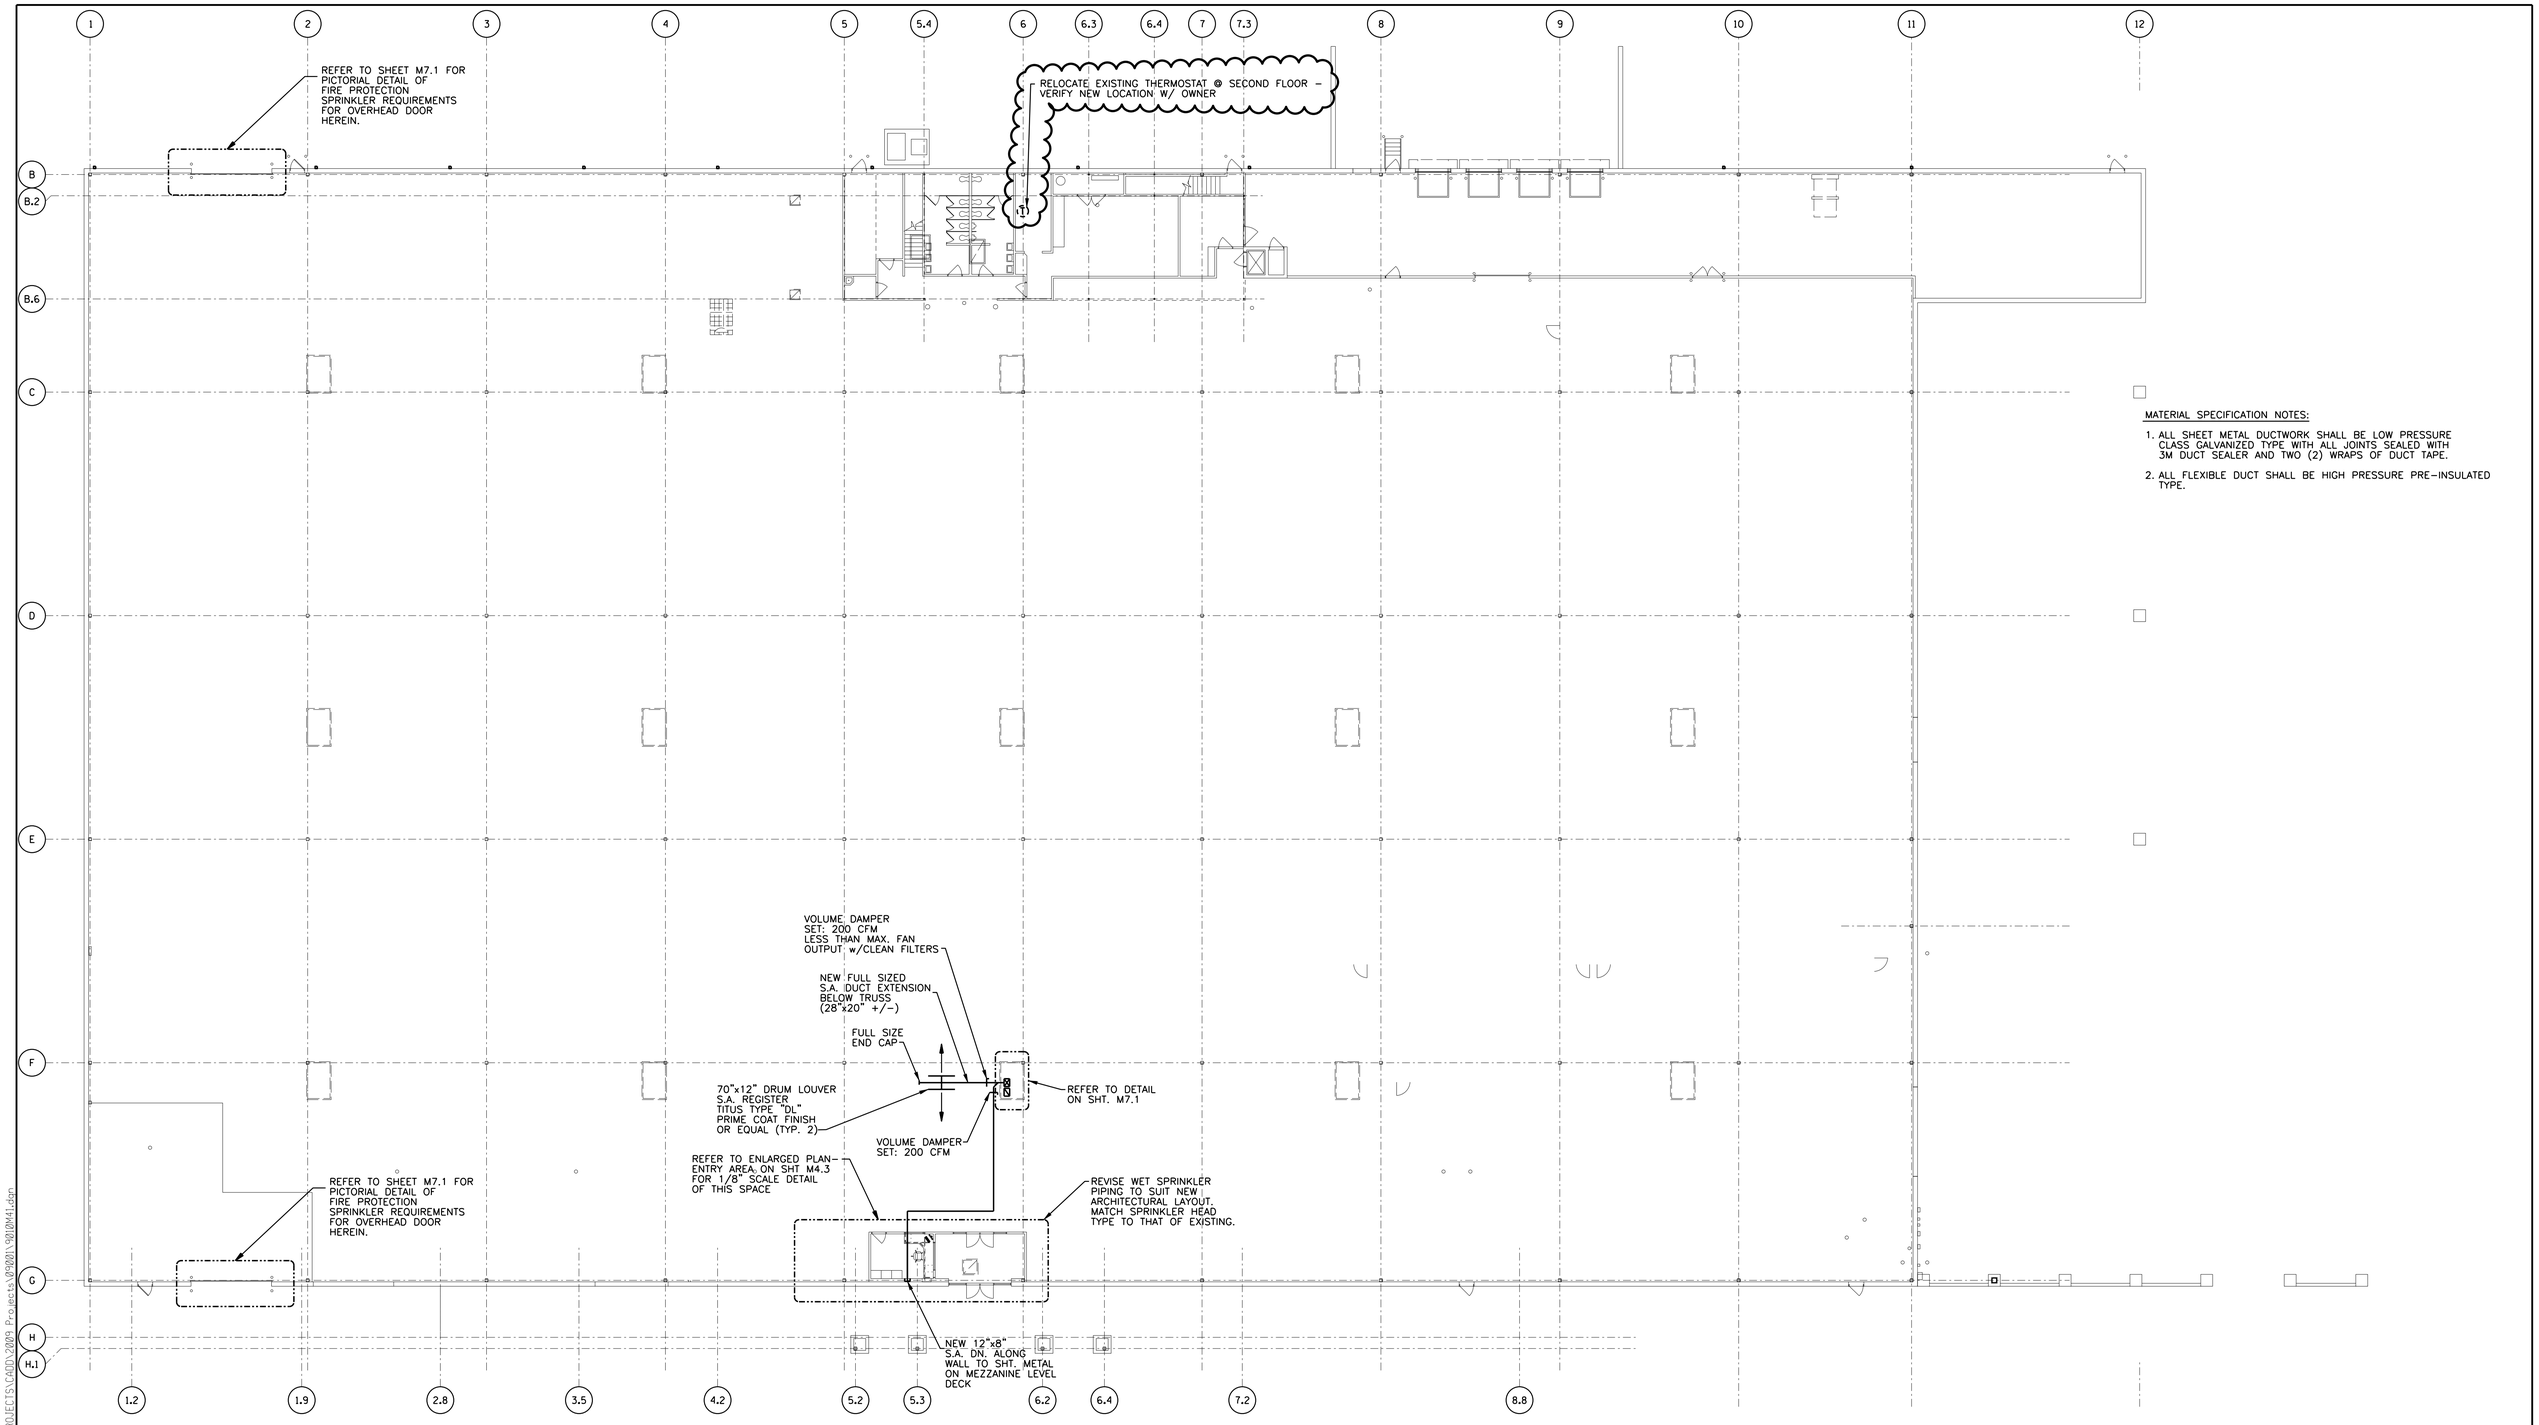

MATERIAL SPECIFICATION NOTES:

1. ALL SHEET METAL DUCTWORK SHALL BE LOW PRESSURE CLASS GALVANIZED TYPE WITH ALL JOINTS SEALED WITH 3M DUCT SEALER AND TWO (2) WRAPS OF DUCT TAPE.
2. ALL FLEXIBLE DUCT SHALL BE HIGH PRESSURE PRE-INSULATED TYPE.

FIRST FLOOR PLAN
SCALE: 1/16"=1'-0"

10/20/09 BAE PROJECTS\CADD\2009 Projects\09001\09001M41.dgn

11/19/2009

DATE	ISSUES/REVISIONS	DATE	ISSUES/REVISIONS	DATE	ISSUES/REVISIONS
07-13-09	DESIGN DEVELOPMENT PHASE				
09-08-09	SITE PLAN REVIEW				
10-30-09	ISSUED FOR BIDS				
11-20-09	ADDENDUM #1				

BEI Associates, Inc.
Architects & Engineers
601 West Fort Street
Detroit, MI 48226
313-963-2300
WWW.BEIASSOCIATES.COM
ARCHITECT / ENGINEER OF RECORD

WAYNE COUNTY DOWNRIVER ANNEX

15800 Northline Road, Southgate MI

Seal:

Drawing Title: FIRST FLOOR PLAN MECHANICAL WORK

Scale: 1/16"=1'-0"
Drawn: DAB
BEI No.: 09001
Arch./Engr.: BS
Drawing No.: **M4.1**